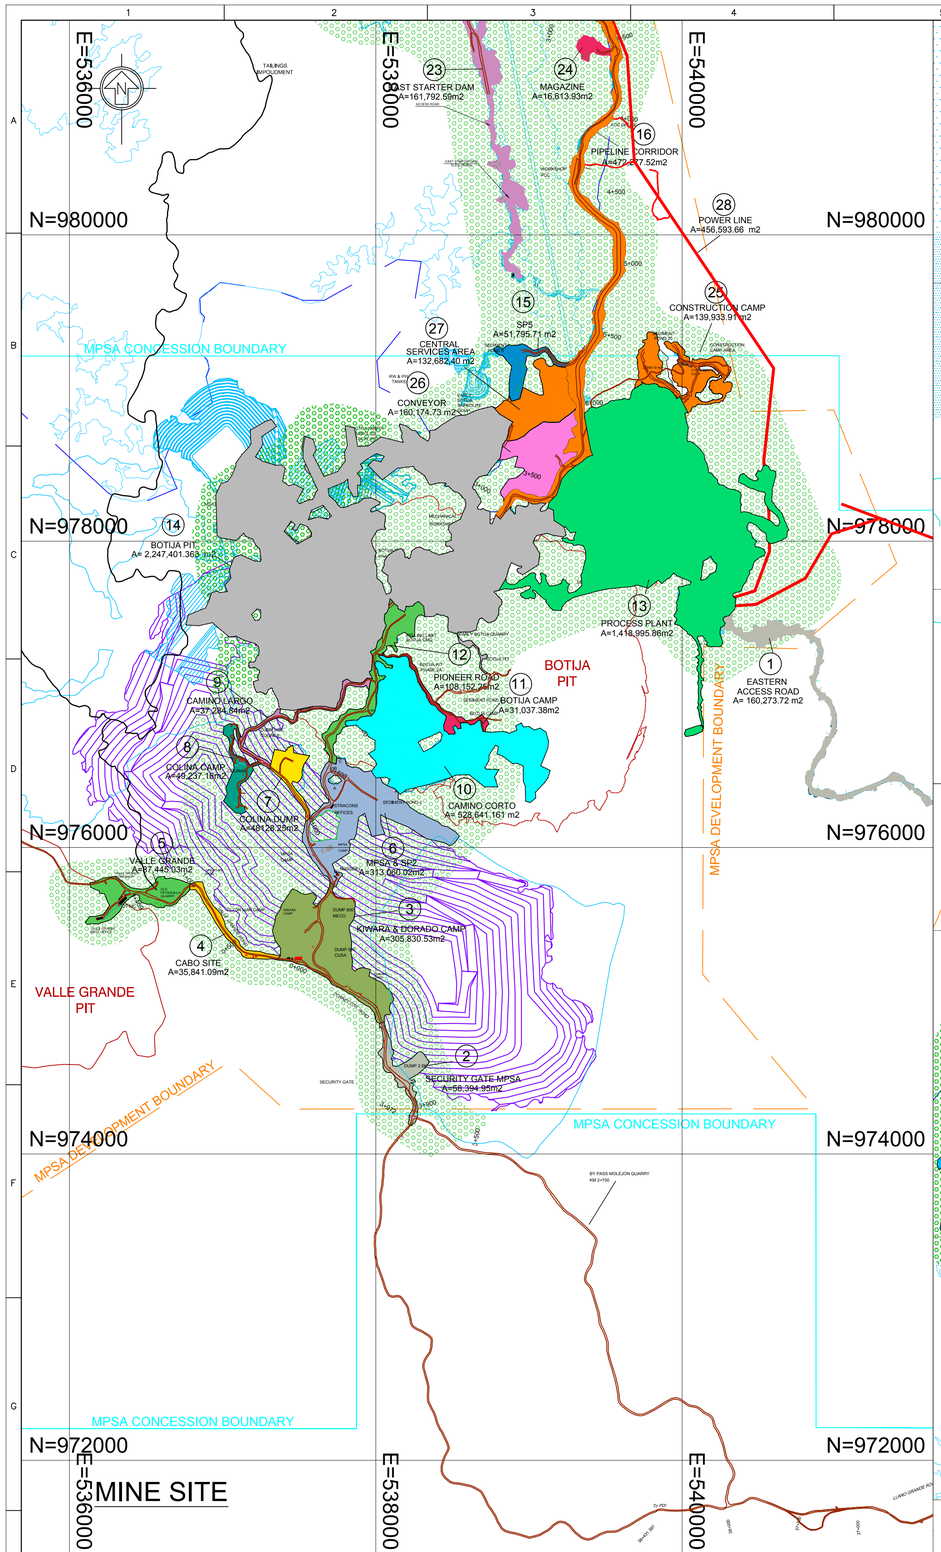

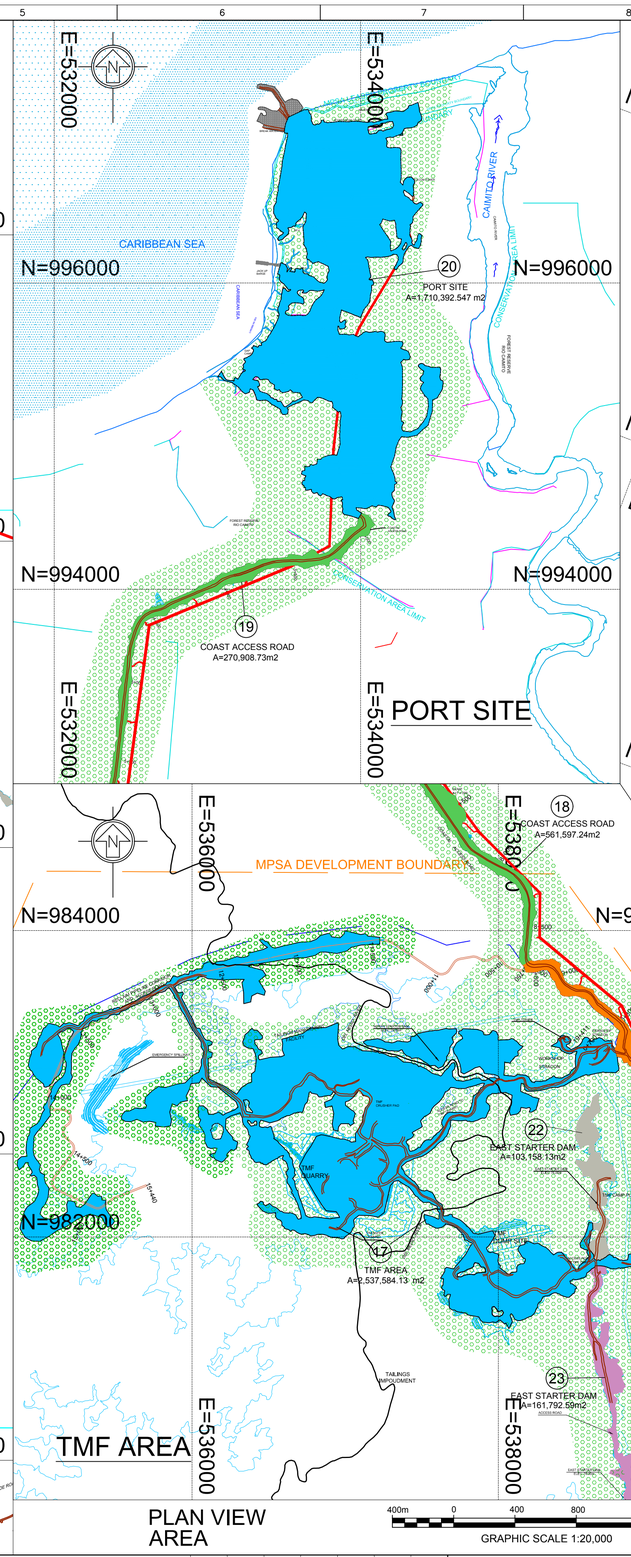

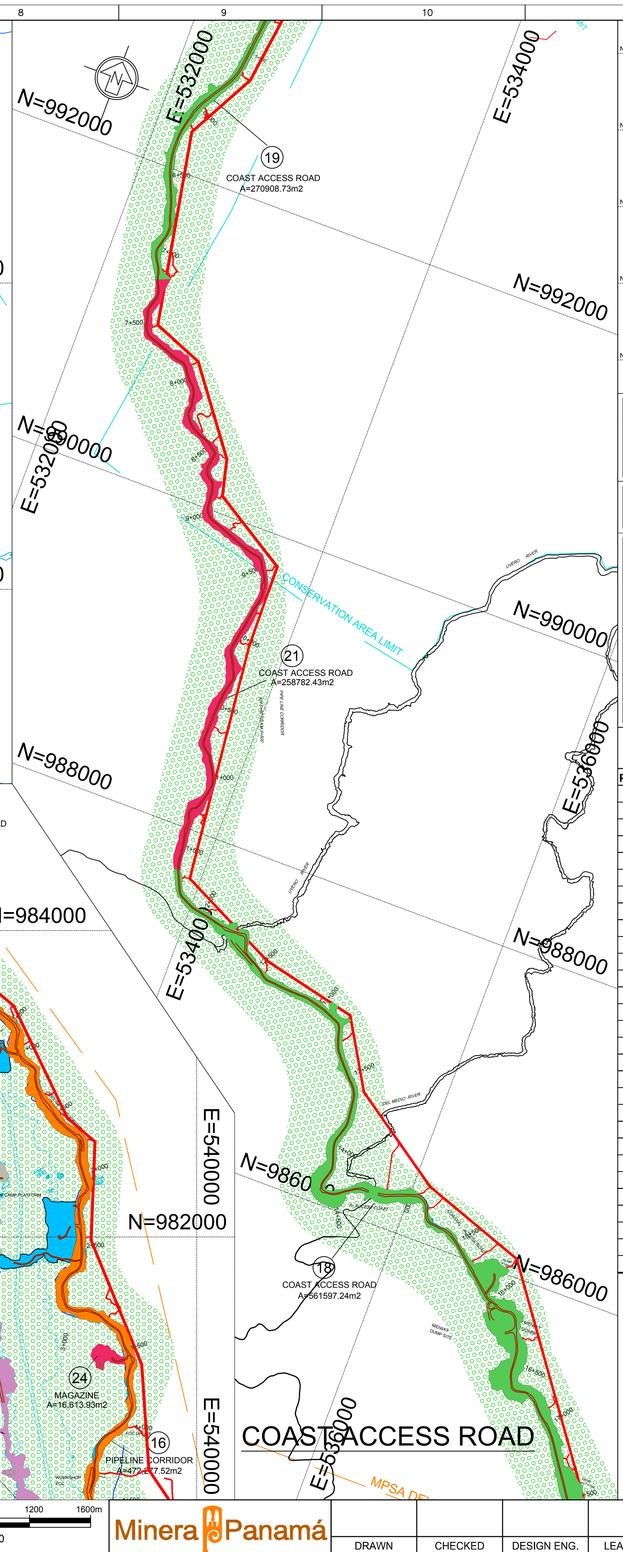

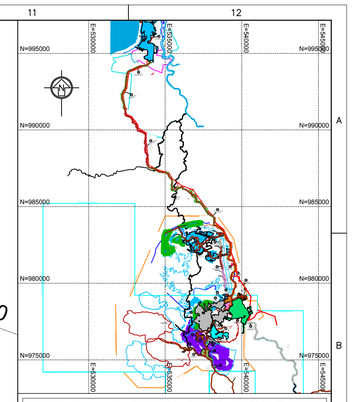

LEGEND

- ROAD
- POLYGON OF FOREST CLEARED
- POLYGON OF FOREST CLEARED
- POLYGON OF INFLUENCE OF WORKS
- MPSA CONCESSION BOUNDARY
- CONSERVATION AREA LIMIT

TABLE

POLYGON OF FOREST CLEARED

POLYGON	SITE	AREA
1	EASTERN ACCESS ROAD	16 Hect +0273.72 m2
2	SECURITY GATE MPSA	5 Hect +8394.95 m2
3	KIWARA & DORADO CAMP	30 Hect +5830.53 m2
4	CABO SITE	3 Hect +5841.09 m2
5	VALLE GRANDE	8 Hect +7445.03 m2
6	MPSA & SP2	31 Hect +3060.02 m2
7	COLINA DUMP	4 Hect +8128.25 m2
8	COLINA CAMP	4 Hect +9237.18 m2
9	CAMINO LARGO	3 Hect +7284.84 m2
10	CAMINO CORTO	52 Hect +8641.16 m2
11	BOTIJA CAMP	3 Hect +1037.38 m2
12	PIONEER ROAD	10 Hect +8152.25 m2
13	PROCESS PLANT	144 Hect +0645.78 m2
14	BOTIJA PIT	224 Hect +7401.36 m2
15	SP5	5 Hect +1795.71 m2
16	PIPELINE CORRIDOR	47 Hect +2277.52 m2
17	TMF AREA	253 Hect +7584.13 m2
18	COAST ACCESS ROAD	56 Hect +1597.24 m2
19	COAST ACCESS ROAD	27 Hect +0908.73 m2
20	PORT SITE	171 Hect +0392.55 m2
21	COAST ACCESS ROAD	25 Hect +8782.43 m2
22	EAST STARTER DAM	10 Hect +3158.13 m2
23	EAST STARTER DAM	16 Hect +1792.59 m2
24	MAGAZINE	1 Hect +6613.93 m2
25	CONSTRUCTION CAMP	13 Hect +9933.91 m2
26	CONVEYOR	16 Hect +0174.73 m2
27	CENTRAL SERVICES AREA	13 Hect +2682.40 m2
28	POWER LINE	45 Hect +6593.66 m2
	TOTAL	**1248 Hect +5661.20 m2**

NOTES:

1. ALL DIMENSIONS, ELEVATIONS AND GRID COORDINATES SHOWN ON THIS DRAWING ARE IN METERS. GRID SHOWN IS REFERENCED TO UTM WGS84 ZONE 17N DATUM.

PLAN VIEW AREA

400m 0 400 800 1200 1600m

GRAPHIC SCALE 1:20,000

Minera Panamá

DRAWN	CHECKED	DESIGN ENG.	LEAD ENG.	DESIGN APP'D	PROJ. APP'D	CLIENT APP'D

DRG No	REFERENCE DRAWINGS	REV	DATE	DESCRIPTION	DRN	CHK'D	DESIGN ENG.	LEAD ENG.	DESIGN APP'D	PROJ. APP'D	CLIENT APP'D

CLIENT MPSA

PROJECT MINA DE COBRE PANAMA

GENERAL PLAN

FIRST QUANTUM MINERALS LTD.

THIS DRAWING IS THE PROPERTY OF MINERA PANAMA S.A (MPSA), AND THE USE AND COPYING THEREOF IS SUBJECT TO THE TERMS OF THE AGREEMENT UNDER WHICH IT WAS PREPARED. THIS DRAWING MAY NOT BE COPIED EXCEPT AS EXPRESSLY PROVIDED THEREIN.

ESTE PLANO ES PROPIEDAD DE MINERA PANAMA S.A (MPSA), SU USO Y REPRODUCCION ESTAN SUJETOS A LOS TERMINOS DEL CONTRATO BAJO EL CUAL FUE PREPARADO. PROHIBIDA SU REPRODUCCION A MENOS QUE SEA EXPRESAMENTE INDICADO.

DRAWING TITLE

COBRE PANAMA PROJECT
FOREST CLEARED AREAS

SCALE	JOB No.	DRG No.	REV.
1:20,000	1824		00

DRAWN	DATE
JOSE PEÑALOZA	08 FEB 2016

Format A1

X:\Topo_Oficina\MPSA 2013\01 DATA\GENERAL PLAN PROJECT\02 DWG\03 AS BUILT\01 DWG\080216-POLYGON OF FOREST CLEARED-AB-JP.dwg